



PT AINUL HAYAT SEJAHTERA
FORMULIR

SOP-004/ENG/TH/VII/2016-F.01

TECHNICAL QUERIES

No Dokumen : MAVSP-P19002-I-014

Subject : HSE

Queries: MODIFIKASI CEROBONG ASAP MESIN GENSET DIESEL

(DESCRIPTION:

MODIFIKASI CEROBONG ASAP MESIN GENSET DIESEL UNTUK UJUNG CEROBONG MENGHADAP KE ATAS UNTUK MENGANTISIPASI EMISI GAS BUANG MENYEBARKAN POLUSI LANGSUNG KE AREA KERJA

BERDASARKAN PERMENLHK NOMER 5 TAHUN 2021

Raised By: R. Erwan Sukendro
Date : 23 November 2023



Responses:

Berikut Terlampir Drawing dan BOQ Terkait penambahan Pipa pada jalur buangan Diesel Generator

Responded By: Ali Faisal Alwini
Date:

SIGN



CS
 CCO



SOP-004/ENG/TH/VII/2016-F.01

PT AINUL HAYAT SEJAHTERA
FORMULIR

TECHNICAL QUERIES

APPENDIX
(PHOTOS)





BILL OF QUANTITY (BoQ)

No.	
Section :	Summary
Date	16/08/2024

PROJECT : MARVEL DESALINATION		DRAWING :	LOCATION :	BOP EDG Shelter		
SUBJECT : MAVSP-P19002-W05-BOQ-M-012		MAVSP-P19002-W05-DR-M-002	REV :	PAGE :	1	OF 1

Summary

Bill Of Quantity



No	Work Item	Unit	Volume	Unit Price	Total Price
Extention Pipa EDG					
A	Jasa Fabrikasi dan Instalasi				
1	Pipa Carbon Steel (CS)				
	Welding Extention Pipa Diesel Generator	dia inch	78.00		
2	Sampling Point EDG				
	Cutting and Welding 20x20cm	m2	0.04		
B	Material List				
	Pipa Carbon Steel SCH 40 DN 325	m	11.35		
	U-Bolt 13" M20 SS304 Thread	set	1.00		
	UNP 160 (160 x 65) HDG (@1btg=6 meter)	btg	1.00		
Sub TOTAL					
TOTAL					

PREPARED : Ali Faisal Alwini
 REVIEWER : Muhammad Rifki Hardika
 REVIEWER : Sori Tua
 APPROVED : Boy Kurniadi

SIGNATURE
 SIGNATURE
 SIGNATURE
 SIGNATURE

DATE: 16/08/2024
 DATE: 16/08/2024
 DATE: 16/08/2024
 DATE: 16/08/2024

DOC. NO.
 MAVSP-P19002-W05-BOQ-M-012

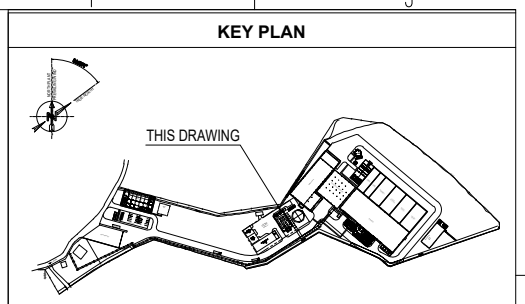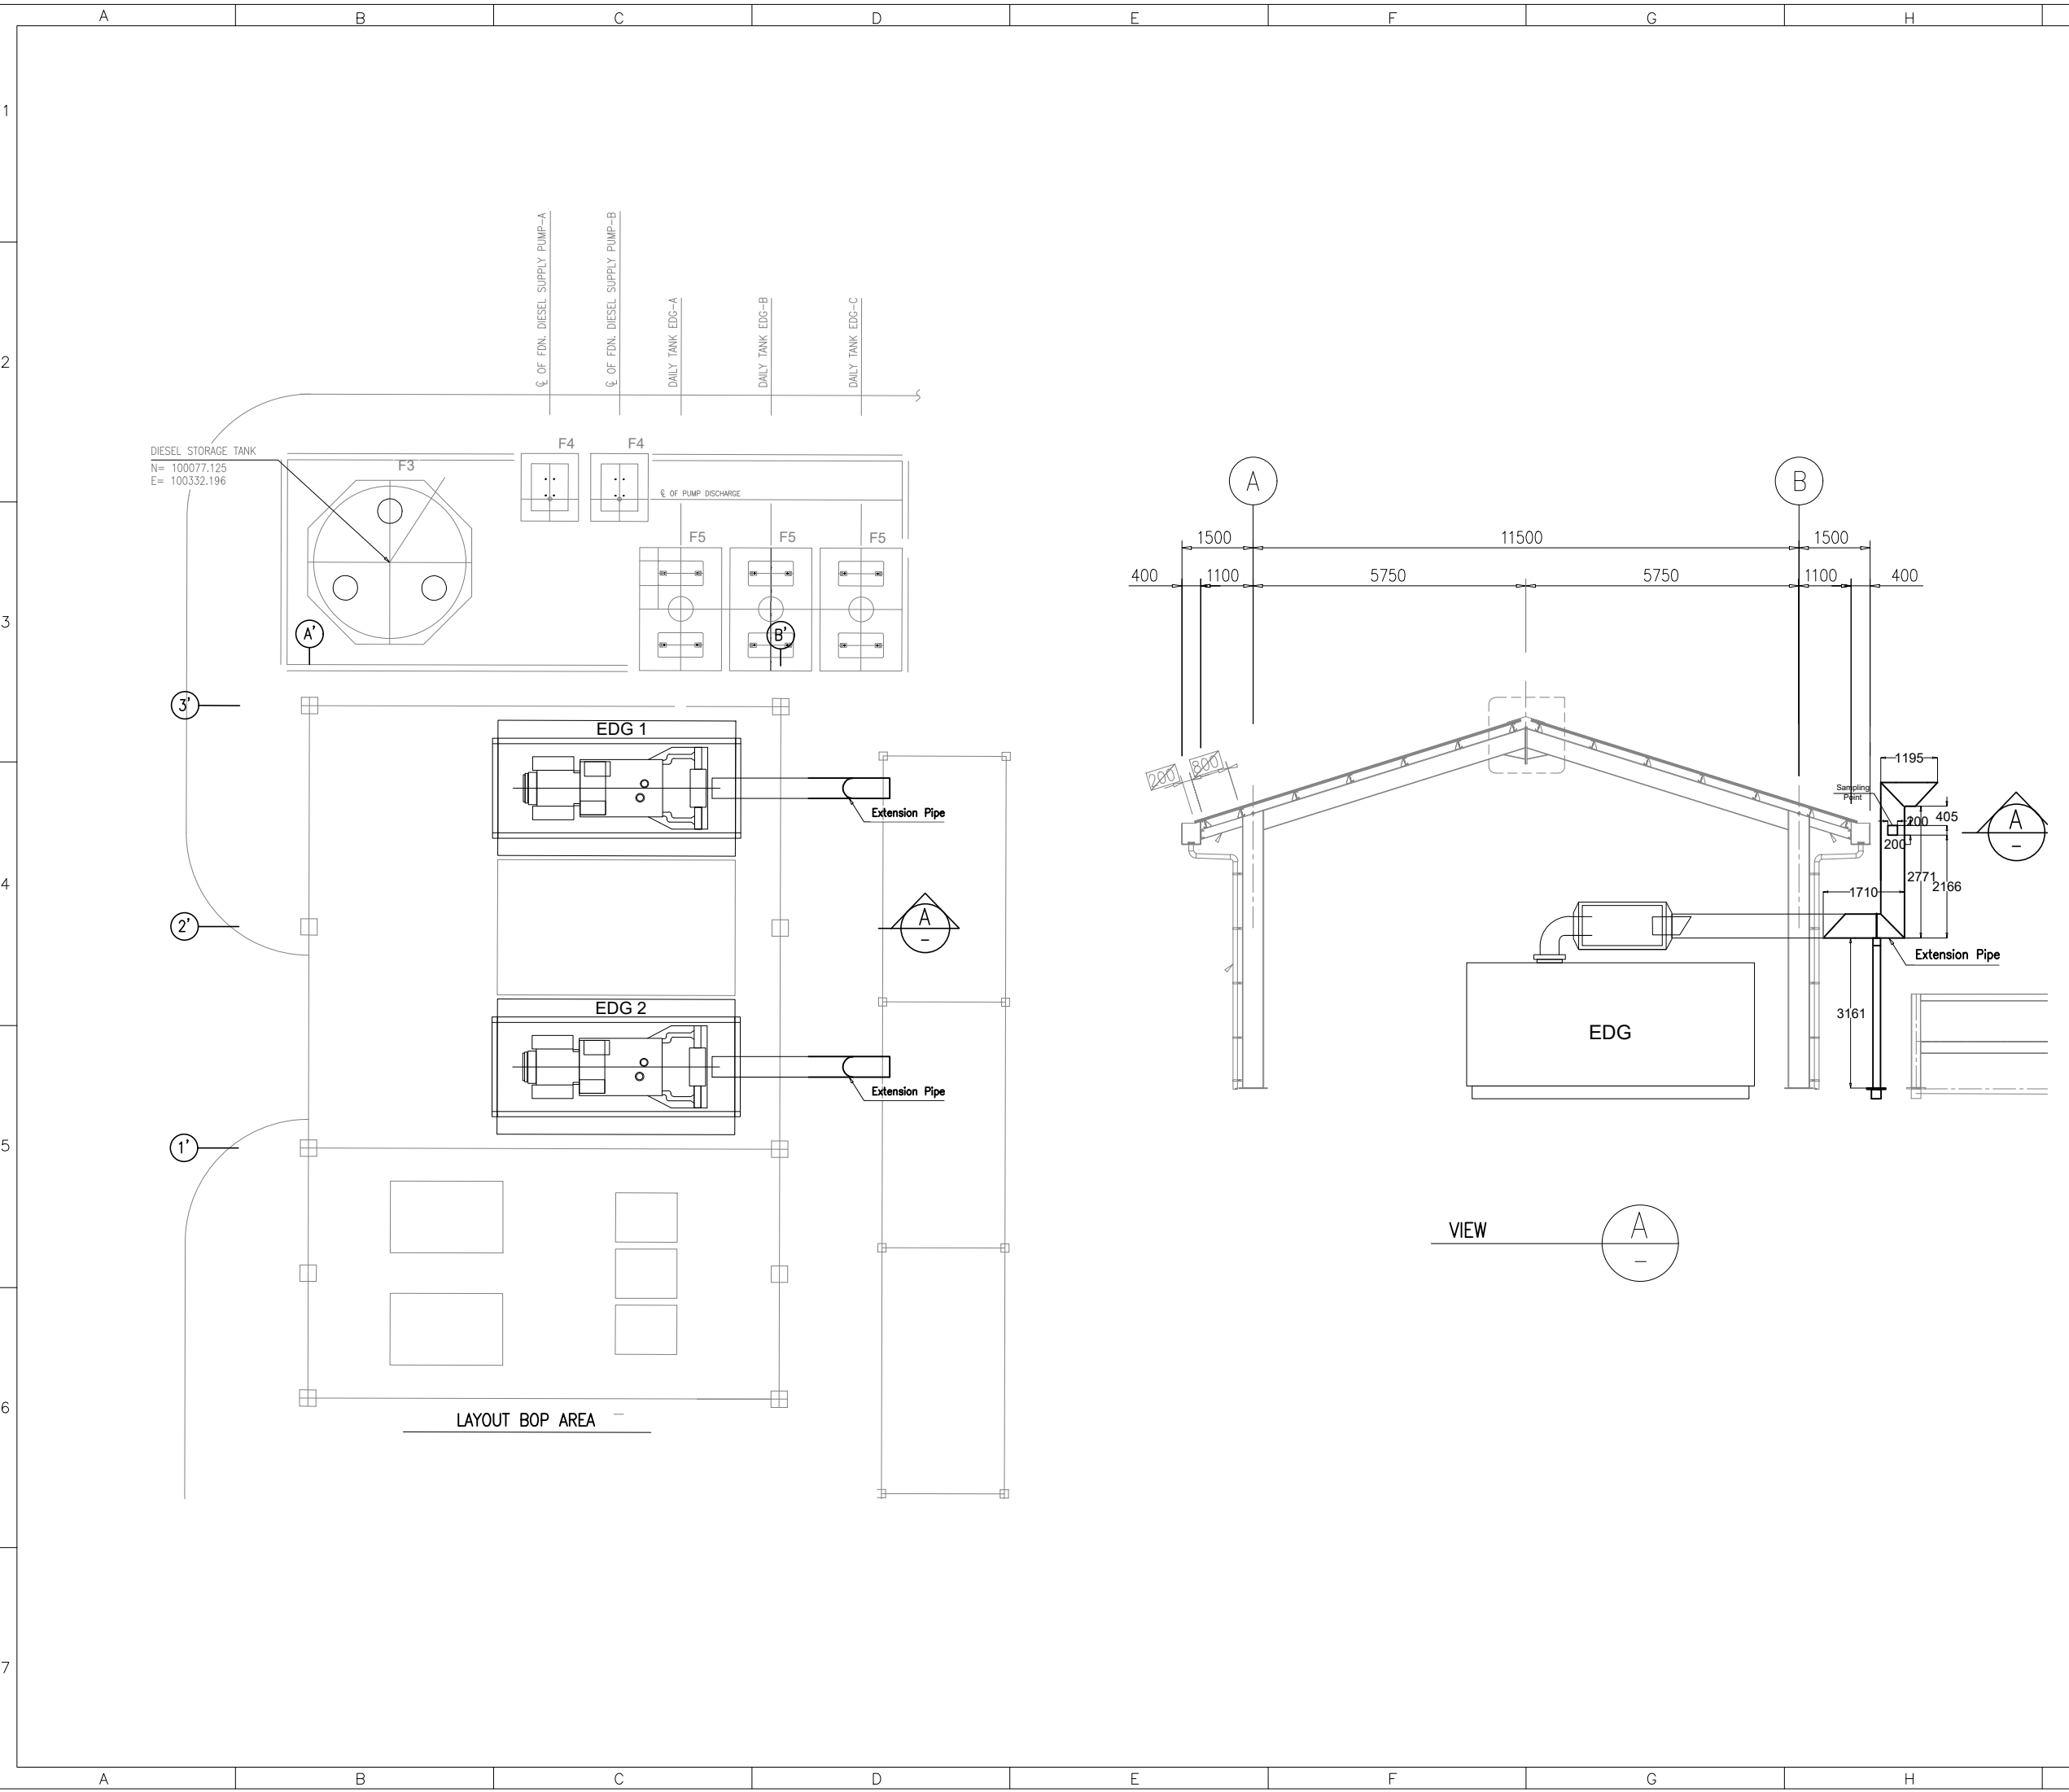

LEGEND AND NOTES

NOTES :

1. ALL DIMENSIONS ARE IN MILLIMETERS UNLESS OTHERWISE SPECIFIED.

2. REFER TO THE GENERAL NOTES FOR MATERIALS AND FINISHES.

3. THE CONTRACTOR SHALL BE RESPONSIBLE FOR OBTAINING ALL NECESSARY PERMITS AND APPROVALS.

4. THE WORK SHALL BE COMPLETED WITHIN THE SPECIFIED TIME FRAME.

5. THE CONTRACTOR SHALL MAINTAIN ACCESS TO ALL EXISTING UTILITIES AND STRUCTURES.

6. THE CONTRACTOR SHALL PROTECT ALL EXISTING PLANT AND EQUIPMENT.

7. THE CONTRACTOR SHALL MAINTAIN A NEAT AND ORDERLY WORK SITE AT ALL TIMES.

8. THE CONTRACTOR SHALL BE RESPONSIBLE FOR DISPOSING OF ALL WASTE AND DEBRIS.

9. THE CONTRACTOR SHALL MAINTAIN A SAFE WORKING ENVIRONMENT AT ALL TIMES.

10. THE CONTRACTOR SHALL BE RESPONSIBLE FOR OBTAINING ALL NECESSARY INSURANCE COVERAGE.

AS BUILT DRAWING

REV	DATE	DESCRIPTION	PREP	CHECK	CHECK	APVD
1	09/SEP/2024	FINAL ISSUE	AFA	MRH	ST	BK
0	06/AGUS/2024	FINAL ISSUE	AFA	MRH	ST	BK

TOTAL OR PARTIAL REPRODUCTION AND/OR UTILIZATION OF THIS DOCUMENT ARE FORBIDDEN WITHOUT PRIOR WRITTEN AUTHORIZATION OF THE OWNER

PT. AINUL HAYAT SEJAHTERA



**DESIGN ENGINEERING AND TOPOGRAPHY
TAMARIS GROUP**

PROJECT NAME :
MARVEL DESALINATION AND SALT PRODUCTION PLANT

DWG. SIZE : A3
SCALE : AS SHOWN
TITLE : **DRAWING FOR
EXTENTION PIPE EDG**
(SHEET 1 OF 1)

CONTRACT NO. :
DRAWING NUMBER : **MAVSP-P19002-W05-DR-M-002-01**

REV. 1